

CITY OF CROSSVILLE
REQUEST FOR QUOTATION

THIS IS NOT AN ORDER

IMPORTANT: Read Instructions Carefully

RETURN QUOTATION TO:

City Clerk/BIDS

CRO# 1635 Date Issued: 03/01/2024

City of Crossville

Delivery required immediately upon award of bid

392 N Main St

For more information, call: To be opened date/hour:

Crossville TN 38555

Billy Poore, 931-484-7631

04/23/2024, 2 p.m. CDT

NOTICE TO BIDDER:

THIS IS NOT AN ORDER. Please enter unit prices, extensions, and amount for items listed herein specified. Be sure the specifications are followed. If you are unable to supply any of the items, please quote on the nearest substitute either on this form, or attach a letter containing such description and it will be considered as part of your quotation. Prices quoted must include all delivery charges to points of delivery indicated hereon. **We reserve the right to accept or reject any or all bids.**

Please submit a bid for GRINDER PUMPS as specified per attached specifications. Please provide warranty options and specific costs related to the warranty when quoting bid price. The terms of the contract will be from July 1, 2024 to June 30, 2025.

	Each	Total
1. Hydromatic HPG200M2 Minimum of 10	\$ _____	\$ _____

Warranty Details _____

	Each	Total
2. Liberty LSG202M-C Submersible grinder pump Minimum of 10	\$ _____	\$ _____

Warranty Details: _____

Bidder's Name _____

Bidder's Address _____

**For further information, contact
Billy Poore, 931-484-7631**

PLEASE SEE NEXT PAGE FOR INSTRUCTIONS

IMPORTANT INSTRUCTIONS TO BIDDERS

1. Each Request for Quote should be in a SEPARATE ENVELOPE and have typed/noted on the envelope the **CRO#, ITEM, OPENING DATE, and TIME. Mailing envelope should be addressed to City of Crossville, ATTN CITY CLERK/BIDS. No electronic submissions will be accepted.**
2. Specifications used in this request for proposal are intended to be open and non-restrictive. Reference to brand names, catalogs, etc., is to establish minimum standards of quality and does not preclude BUYER's consideration of proposals on comparable quality. All bidders state brand name and catalog number of product proposed.
3. All prices quoted should be on a delivered prepaid basis to the F.O.B. destination shown in the shipping instructions.
4. Insert time discount terms, in any, in space provided. Discounts are computed from date of delivery at destination or date of receipt of properly executed vendor's invoice at agency indicated above, whichever is later.
5. The City of Crossville, a municipality, is exempt from sales tax with respect to materials that it purchases for municipal projects; however, the contractor who installs, applies, or otherwise uses such materials, is liable for the use tax of those materials.
6. Unless otherwise indicated, quotations should be submitted on this form indicating unit price, total extension of each item, and grand total of quotation. In care of error in the extension prices, the unit price will govern.

NOTICE: PROPOSALS WILL BE REJECTED
UNLESS SIGNED IN INK

SIGNED BY: _____

Print Name: _____

Firm: _____

Address: _____

City: _____

State: _____ ZIP: _____

Date: _____ Phone: _____

EMAIL: _____

In submitting this bid, it is expressly agreed that upon proper acceptance by the City of Crossville of any or all items proposed, a contract shall thereby be created with respect to the items accepted.

Liberty Grinder Pump Specifications

Pump

Liberty Model LSG202M-C submersible grinder pump equipped with 2.0 HP, 3450 RPM, 230 Volt/1-phase motor, dual seals, V-slice cutting system made of hardened 440 stainless steel, 1 ¼" discharge, 30' power cord and cast iron construction.

Tank

42" x 42" fiberglass basin system to include the following: straight wall (with anti-float), solid fiberglass cover with max load limit 300 lb per square foot, anti-siphon valve, quick disconnect discharge assembly with stainless steel riser pipe, flex hose, cast iron ball check valve and extension handle, gate valve assembly to include a stainless steel sealing flange adapter, 1-1/4" brass gate valve and stainless steel pipe nipple, 1-1/4" stainless steel NPT discharge hub, 2" and 4" adaptaflex grommet to be supplied for field installation.

Panel


SX-Series simplex control panel, Model SXHC24=3, wire for 230 volt single phase service to operate the LSG202M-C pump, and 115 volt circuit to operate the control/alarm power, to include high water alarm. Control panel to include the following: NEXA 4X enclosure, red beacon and horn, exterior test normal silence switch, three level float switches with 30' cord with weight. **Panel is to have lockable latches.**

Warranty

Warranty details to be included with bid documentation

Note

No tank vent in lid

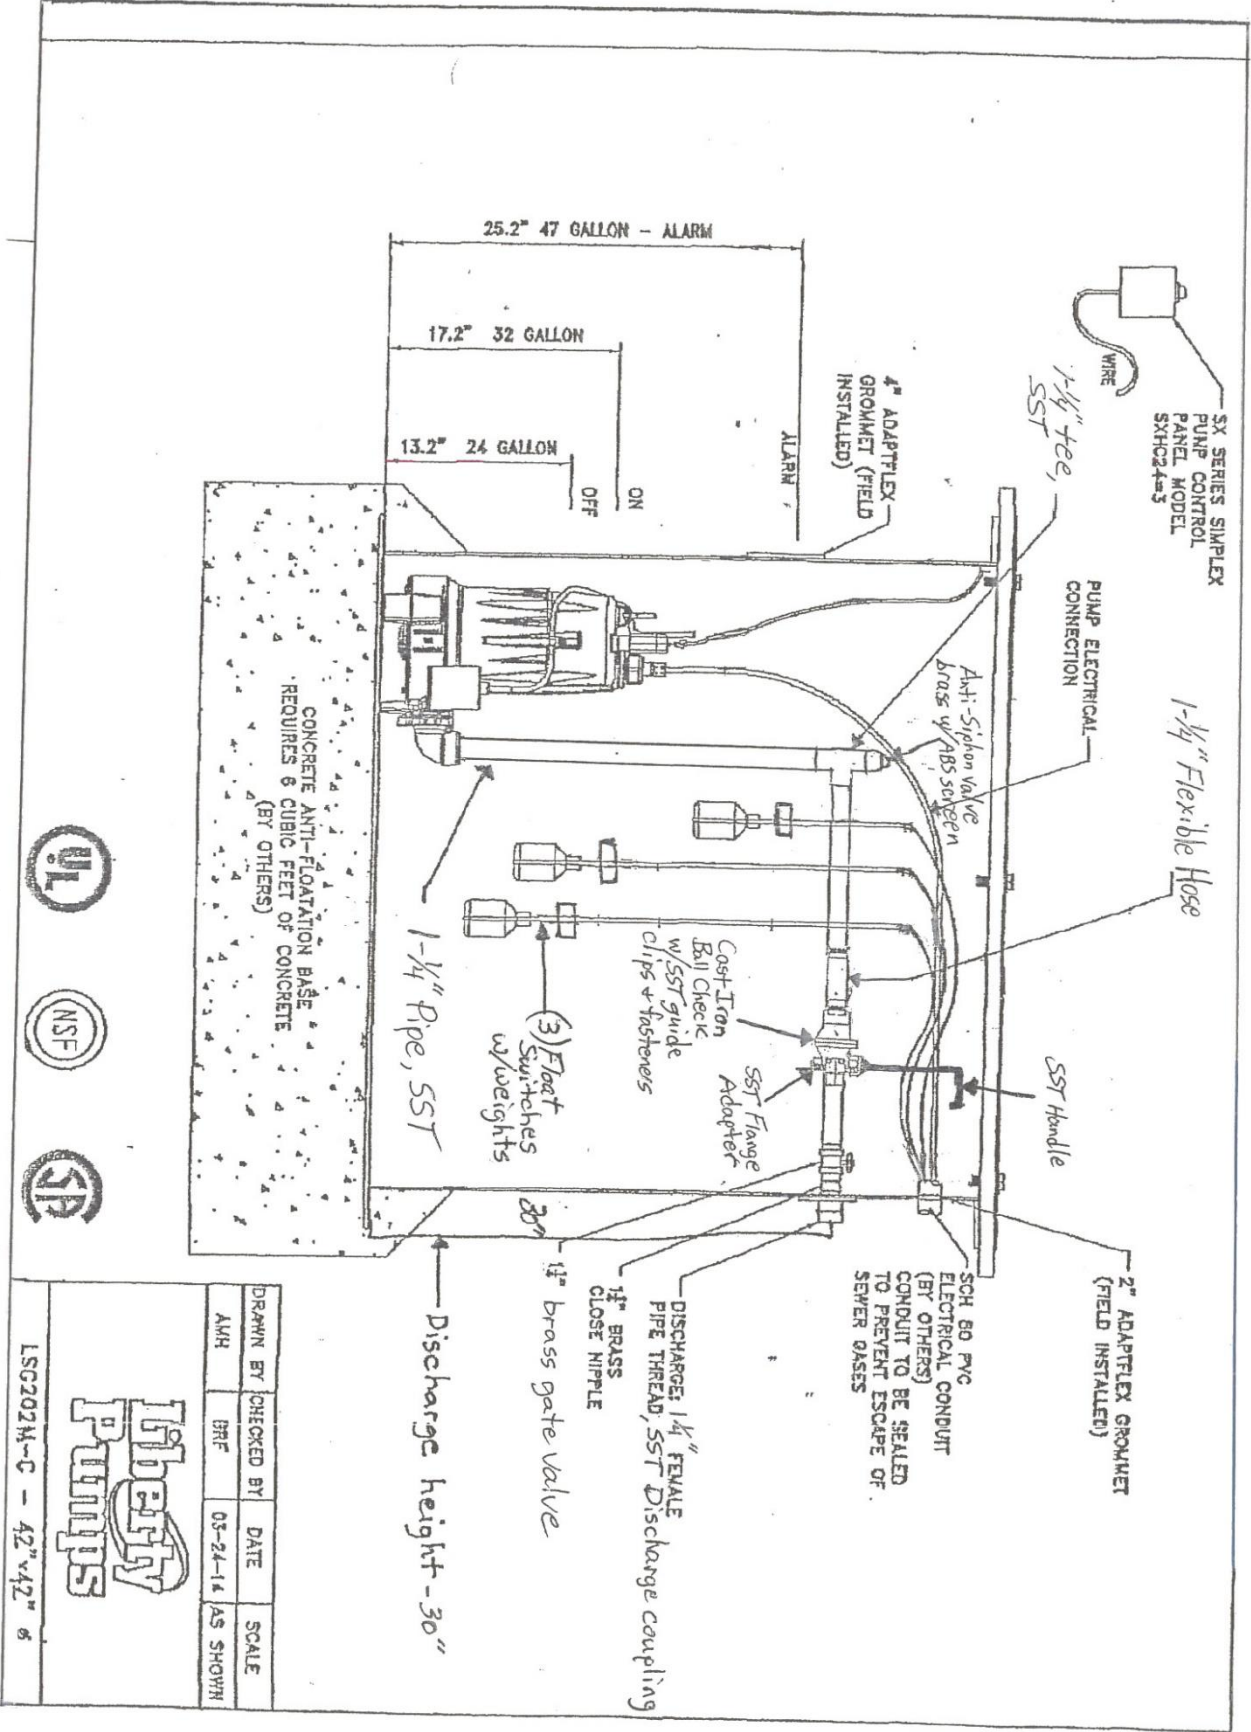

DRAWN BY	CHECKED BY	DATE	SCALE
AMH	BRF	05-24-14	AS SHOWN

Liberty Pumps
 LSC202M-C - 42" x 42" 6

Hydromatic Grinder Pump Specifications

Pump

Hydromatic Model HPG200M2 submersible grinder pump equipped with 2.0 HP, 3450 RPM, 230 volt/1-phase motor, double mechanical seal, 5.00" bronze impeller, 1 ¼" vertical NPT discharge, 30 ft. power cord and standard cast iron construction.

Tank

42" x 42" fiberglass basin system to include the following: straight walls (with anti-float), solid fiberglass cover with max load limit 300 lb. per square foot, *anti-siphon valve, quick disconnect discharge assembly with stainless steel riser pipe, flex hose, cast iron ball check valve and extension handle, gate valve assembly to include a stainless steel sealing flange adapter, 1 ¼" brass gate valve and stainless steel pipe nipple, 1 ¼" stainless steel NPT discharge hub, 3-hole stainless steel float bracket, 2" and 4" adaptaflex grommet to be supplied for field installation, stainless steel pump ring stand.

Panel

Simplex control panel to be provided with each pump system. Control panel to be wired for 230 volt, single phase service. Control panel enclosure to be NEMA 4X FRP and approximately 16" x 14" x 7". Control panel will utilize an aluminum back plate for mounting components. Components to include: pump breaker, control power breaker, motor contactor and overload, start and run capacitors, start relay, HOA switch, run light, seal fail light, high water alarm with top-mounted flashing light and audible buzzer, push-to-silence button. Control panel to be provided with 3 each float switches with a 30-foot cord with weight.

Warranty

Warranty to be included with bid.


Delivery

Bidder is responsible for delivery to 376 Sparta Highway, Crossville TN 38555

**NOTE: 1.No Stainless Steel lift chain or rope.*

- 2. Discharge adapter height, change to 30" and adjust 1 ¼" Stainless Steel pipe coming out of pump to match.*
- 3. No electrical exit*
- 4. No float bracket*
- 5. No junction box*

Hydromatic Pump Unit

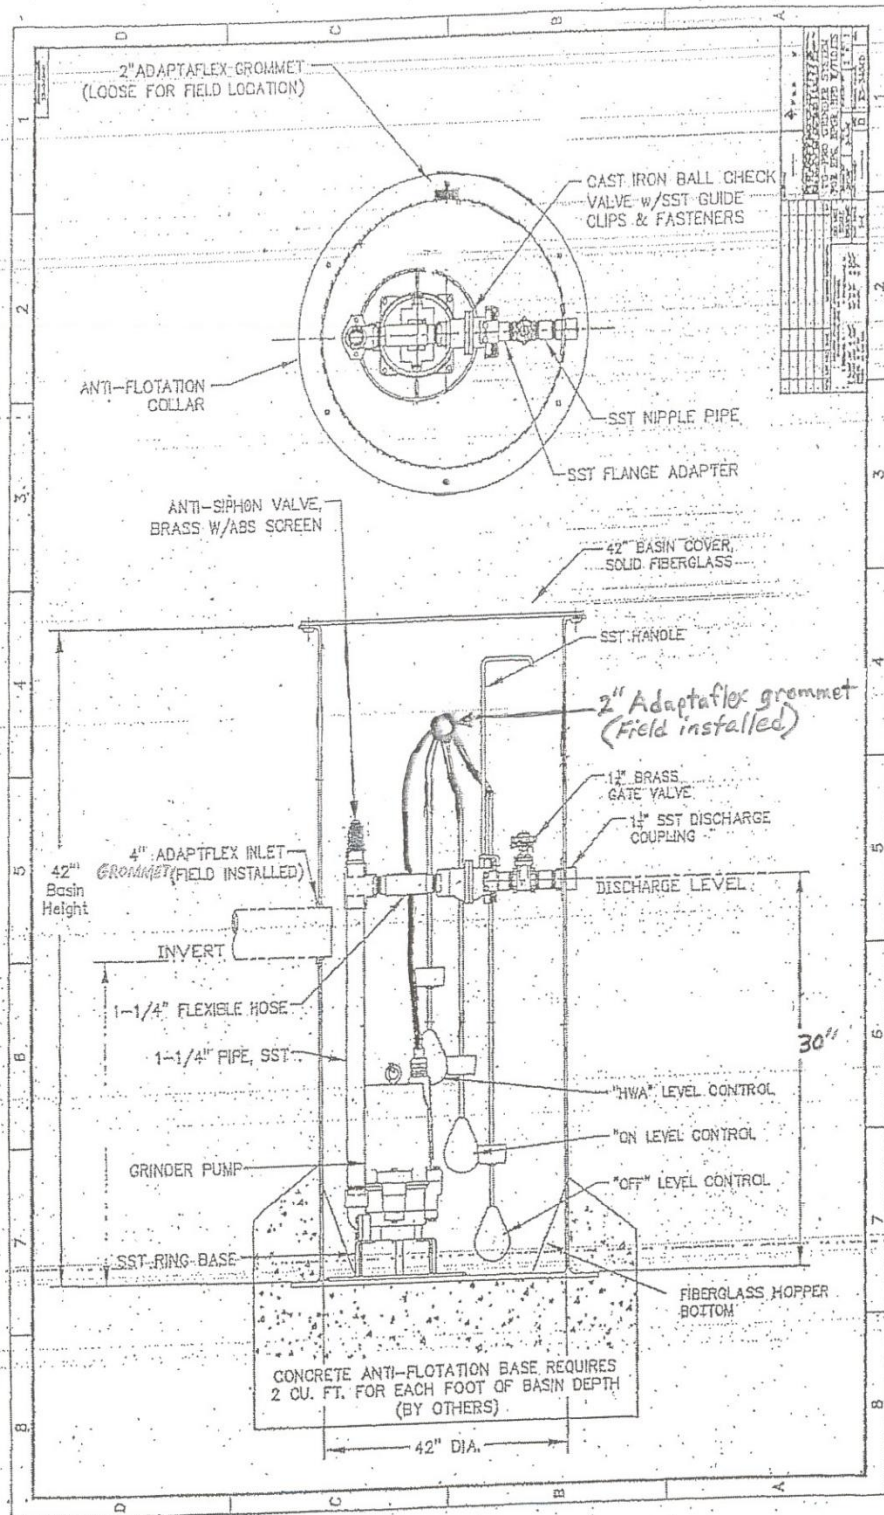

PUBLIC NOTICE

TITLE VI OF THE 1964 CIVIL RIGHTS ACT

“No person in the United States shall, on the ground of race, color or national origin, be excluded from participation in, be denied the benefits of, or be subjected to discrimination under any program or activity receiving federal financial assistance.”

The City of Crossville provides benefits and services such as police protection, fire protection, water service, sewer service, sanitation service, infrastructure needs, and other related municipal services. The City also provides funds to certain non-profit organizations.

Anyone who believes that an agency or local government receiving the federal funding mentioned above has discriminated against someone on the basis of race, color or national origin has a right to file a complaint within 180 days of the alleged discrimination.

Leah Crockett
Title VI Coordinator

Please sign and return to the City of Crossville verifying that your company is in compliance with the above Title VI, 1964 Civil Rights Act.

Authorized Signature

Company

Print Name

Please return to: City of Crossville
 392 N. Main Street
 Crossville, TN 38555

IRAN DIVESTMENT ACT

In compliance with the Iran Divestment Act (State of Tennessee 2016, Public Chapter No. 817), which became effective on July 1, 2016, certification is required of all bidders on contracts over \$1,000.

By submission of this bid, each bidder and each person signing on behalf of any bidder certifies, and in the case of a joint bid each party hereto certifies as to its own organization, under penalty of perjury, that to the best of its knowledge and belief that each bidder is not on the list created pursuant to T.C.A. § 12-12-106.

I affirm, under the penalties of perjury, this statement to be true and correct.

Date

Signature of Bidder

Company

A bid shall not be considered for award nor shall any award be made where the foregoing certification has not been complied with; provided, however, that if in any case the bidder cannot make the foregoing certification, the bidder shall so state and shall furnish with the bid a signed statement which sets forth in detail the reasons therefor. The City of Crossville may award a bid to a bidder who cannot make the certification, on a case-by-case basis, if:

- (1) The investment activities in Iran were made before July 1, 2016, the investment activities in Iran have not been expanded or renewed on or after July 1, 2016, and the person has adopted, publicized, and is implementing a formal plan to cease the investment activities in Iran and to refrain from engaging in any new investments in Iran; or
- (2) The City of Crossville makes a determination that the goods or services are necessary for the City of Crossville to perform its functions and that, absent such an exemption, the political subdivision will be unable to obtain the goods or services for which the contract is offered. Such determination shall be made in writing and shall be a public document.